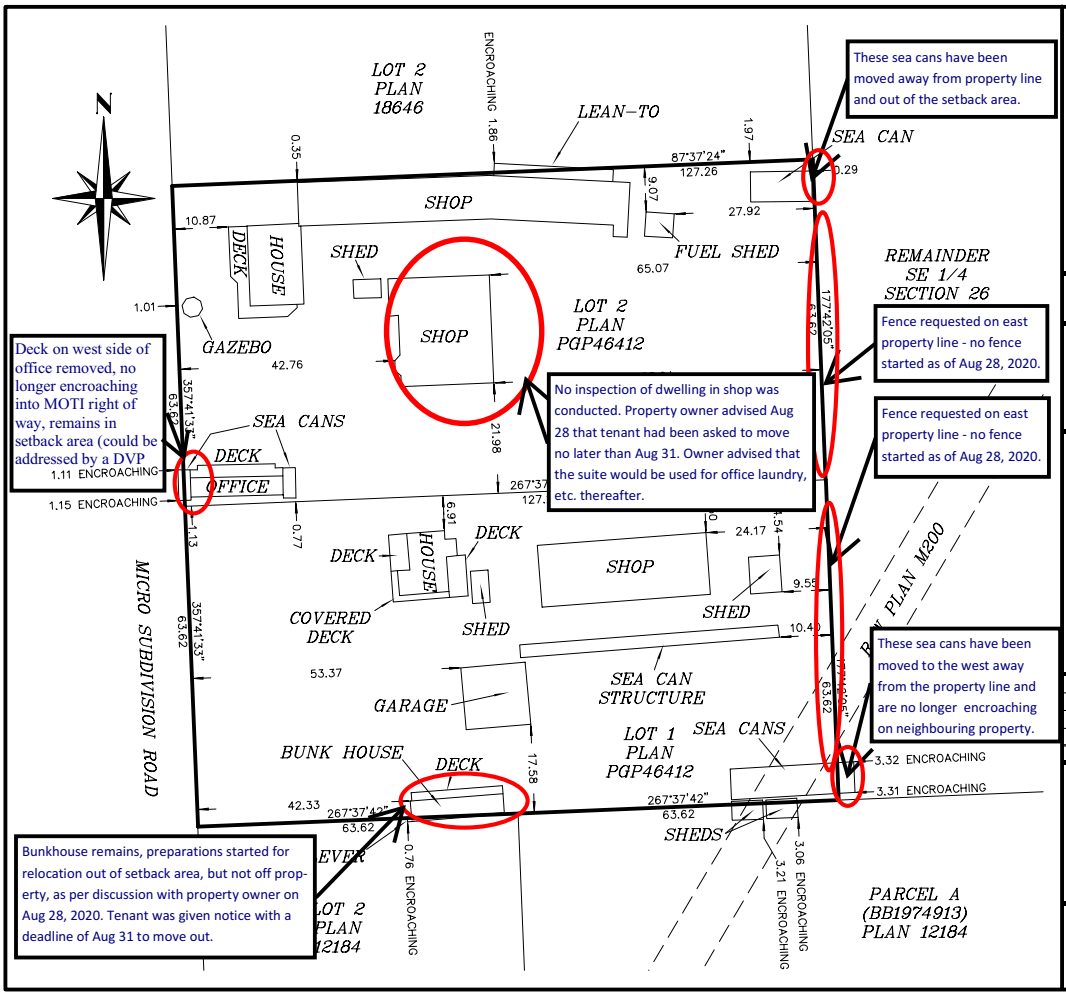

SITE PLAN OF LOTS 1 & 2 SECTION 26 TOWNSHIP 78 RANGE 15 W6M PEACE RIVER DISTRICT PLAN PGP46412

BCGS 93P.079

P.I.D. 024-932-680, 024-932-744

0 1:750 25

PRECISION PROPERTIES LTD

NOTES:
- All Dimensions are in metres and decimals thereof.
- As-built survey completed January 31, 2020.
- Site plan show above ground features only.

Rev	Revision Description	Date(y/m/d)	By:
0	Original Plan Prepared	2020/01/31	NM

This Plan was prepared for asbuilt purposes and is for the exclusive use of our client. The signatory accepts no responsibility or liability for any damages that may be suffered by a third party as a result of reproduction, transmission or alteration to this document without consent of the signatory.

© 2020 B. ELLIOTT B.C.L.S.

Tryon Land Surveying Ltd.
Dawson Creek 250-782-5868
Fort St John 250-262-0031
www.tryongroup.ca

TRYON PROFESSIONAL GROUP

TRYON FILE: 2020-0016-1